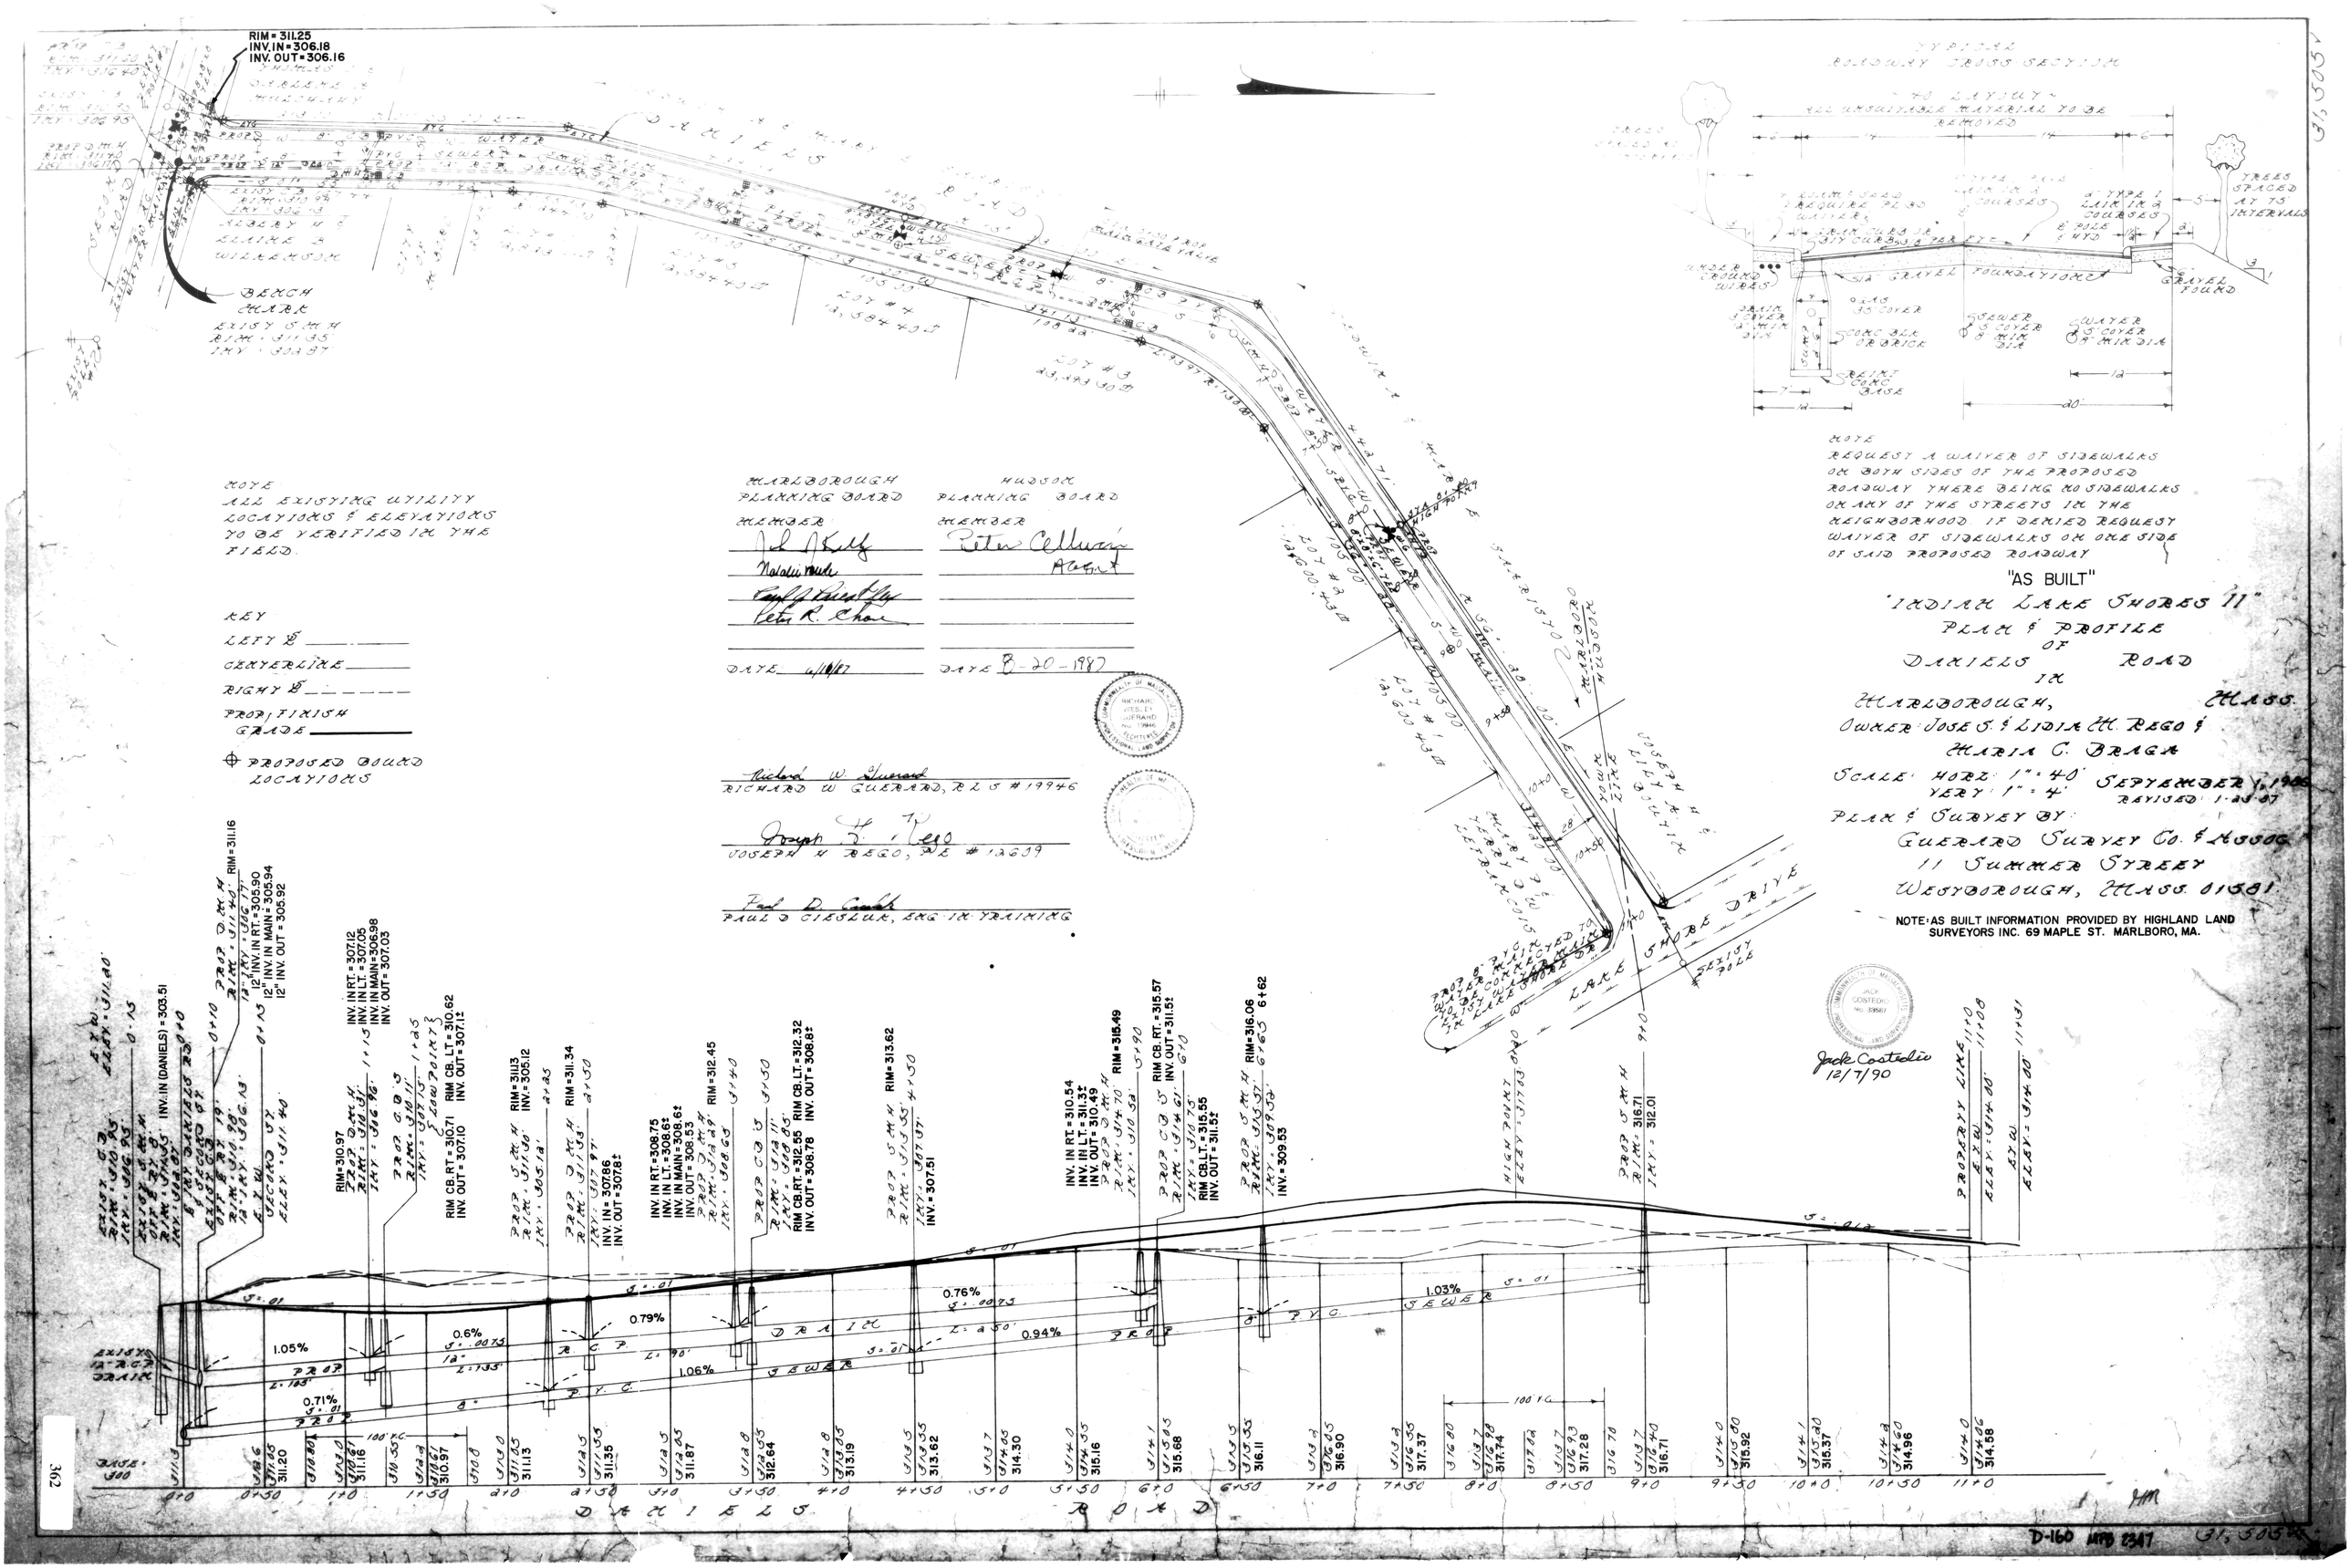

"AS BUILT"

"INDIAN LAKE SHORES II"

PLAN & PROFILE OF DANIELS ROAD IN MARLBOROUGH, MASS.

OWNER: JOSE S. & LIDIA M. REGO & MARIA C. BRAGA

SCALE: HORZ: 1" = 40' VERT: 1" = 4'

SEPTEMBER 1, 1986 REVISED: 1-23-87

PLAN & SURVEY BY:
GUERARD SURVEY CO. & ASSOC.
11 SUMMER STREET
WESTBOROUGH, MASS. 01581

NOTE: AS BUILT INFORMATION PROVIDED BY HIGHLAND LAND SURVEYORS INC. 69 MAPLE ST. MARLBORO, MA.